


WALL SCHEDULE

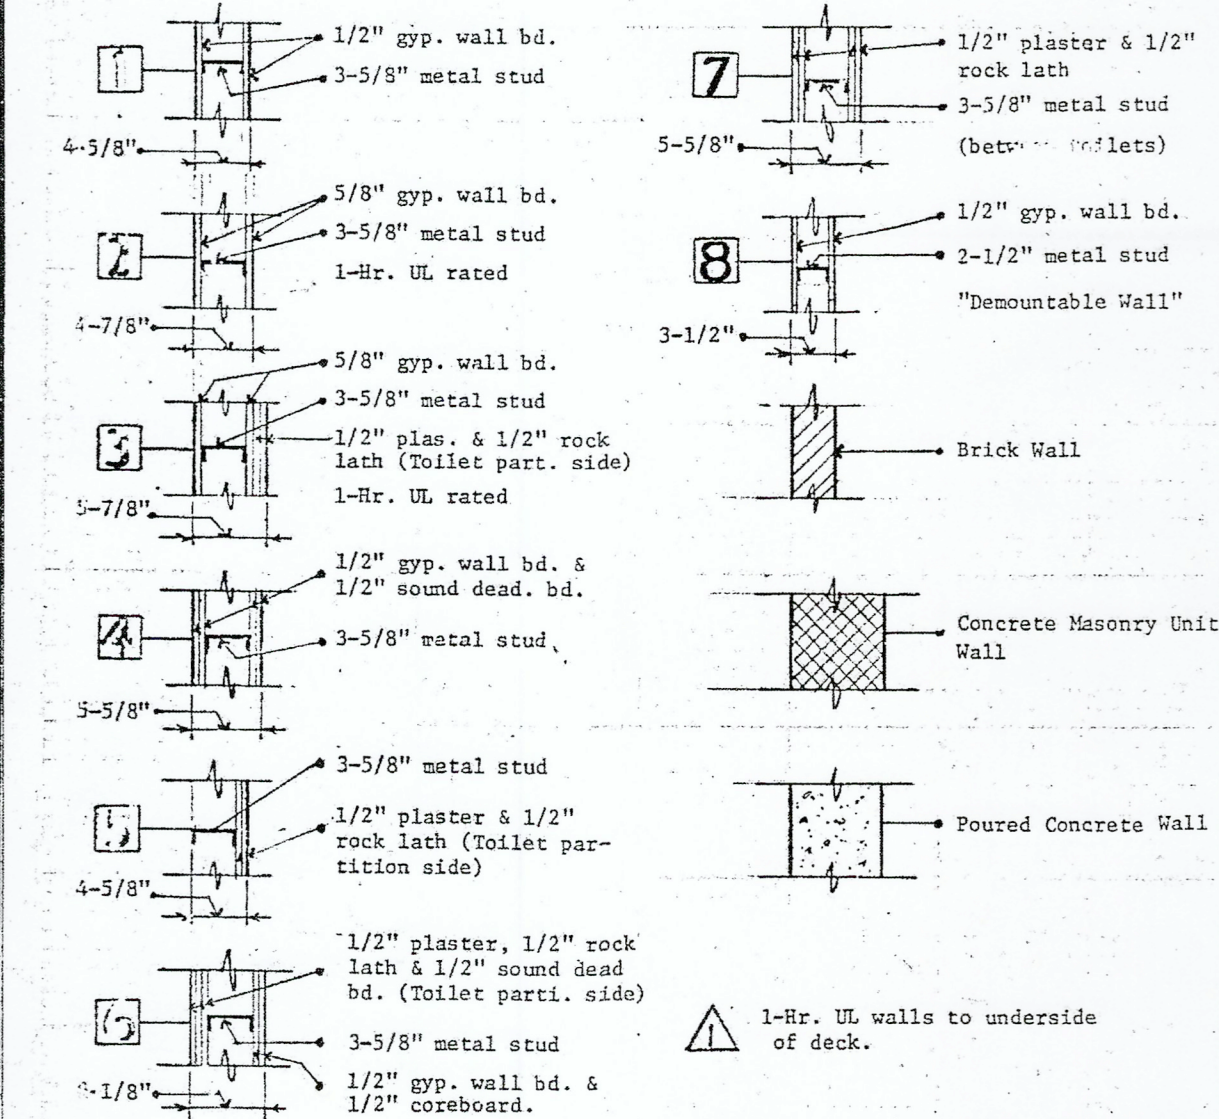

▲ 1-Hr. UL walls to underside of deck.

▲ 2-Hr. UL walls to underside of deck.

Walls to underside of deck.


Walls to underside of ceiling.

All masonry walls to underside of deck.

Fixed Camera

PTZ camera

monitor

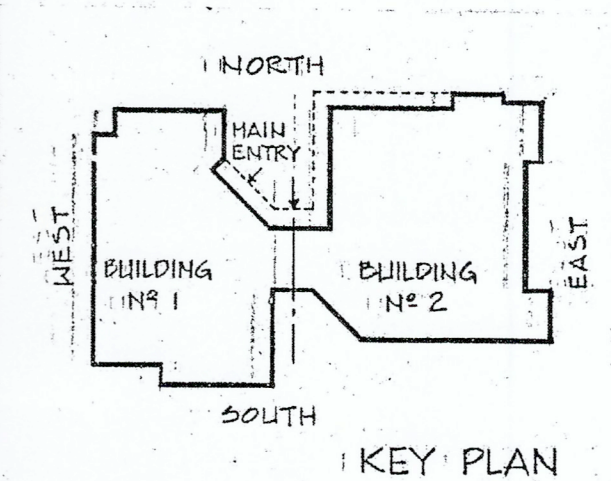

GENERAL NOTES:


DIMENSIONS FOR ALL DEMOUNTABLE PARTITIONS ARE TO CENTERLINES OF THESE PARTITIONS ALL OTHER DIMENSIONS ARE TO FINISH FACE OF MASONRY.

DIMENSIONS AT STAIRS ARE TO NOMINAL FACE OF MASONRY DIMENSION UNLESS OTHERWISE INDICATED.

ALL VERTICAL PIPING AND DUCT CHASES SHALL HAVE METAL STUDS AND GYPSUM WALLBOARD ENCLOSURE.

ALL TOILET ROOMS SHALL RECEIVE THE FOLLOWING:

S.D. = SOAP DISPENSER
T.T.D. = TOILET TISSUE DISPENSER
T.D.D. = TOWEL DISPENSER AND DISPOSAL
M. = MIRROR - TILTED MIRROR AT HANDICAPPED LAVATORY
G.B. = GRAB BARS - HANDICAPPED STALLS

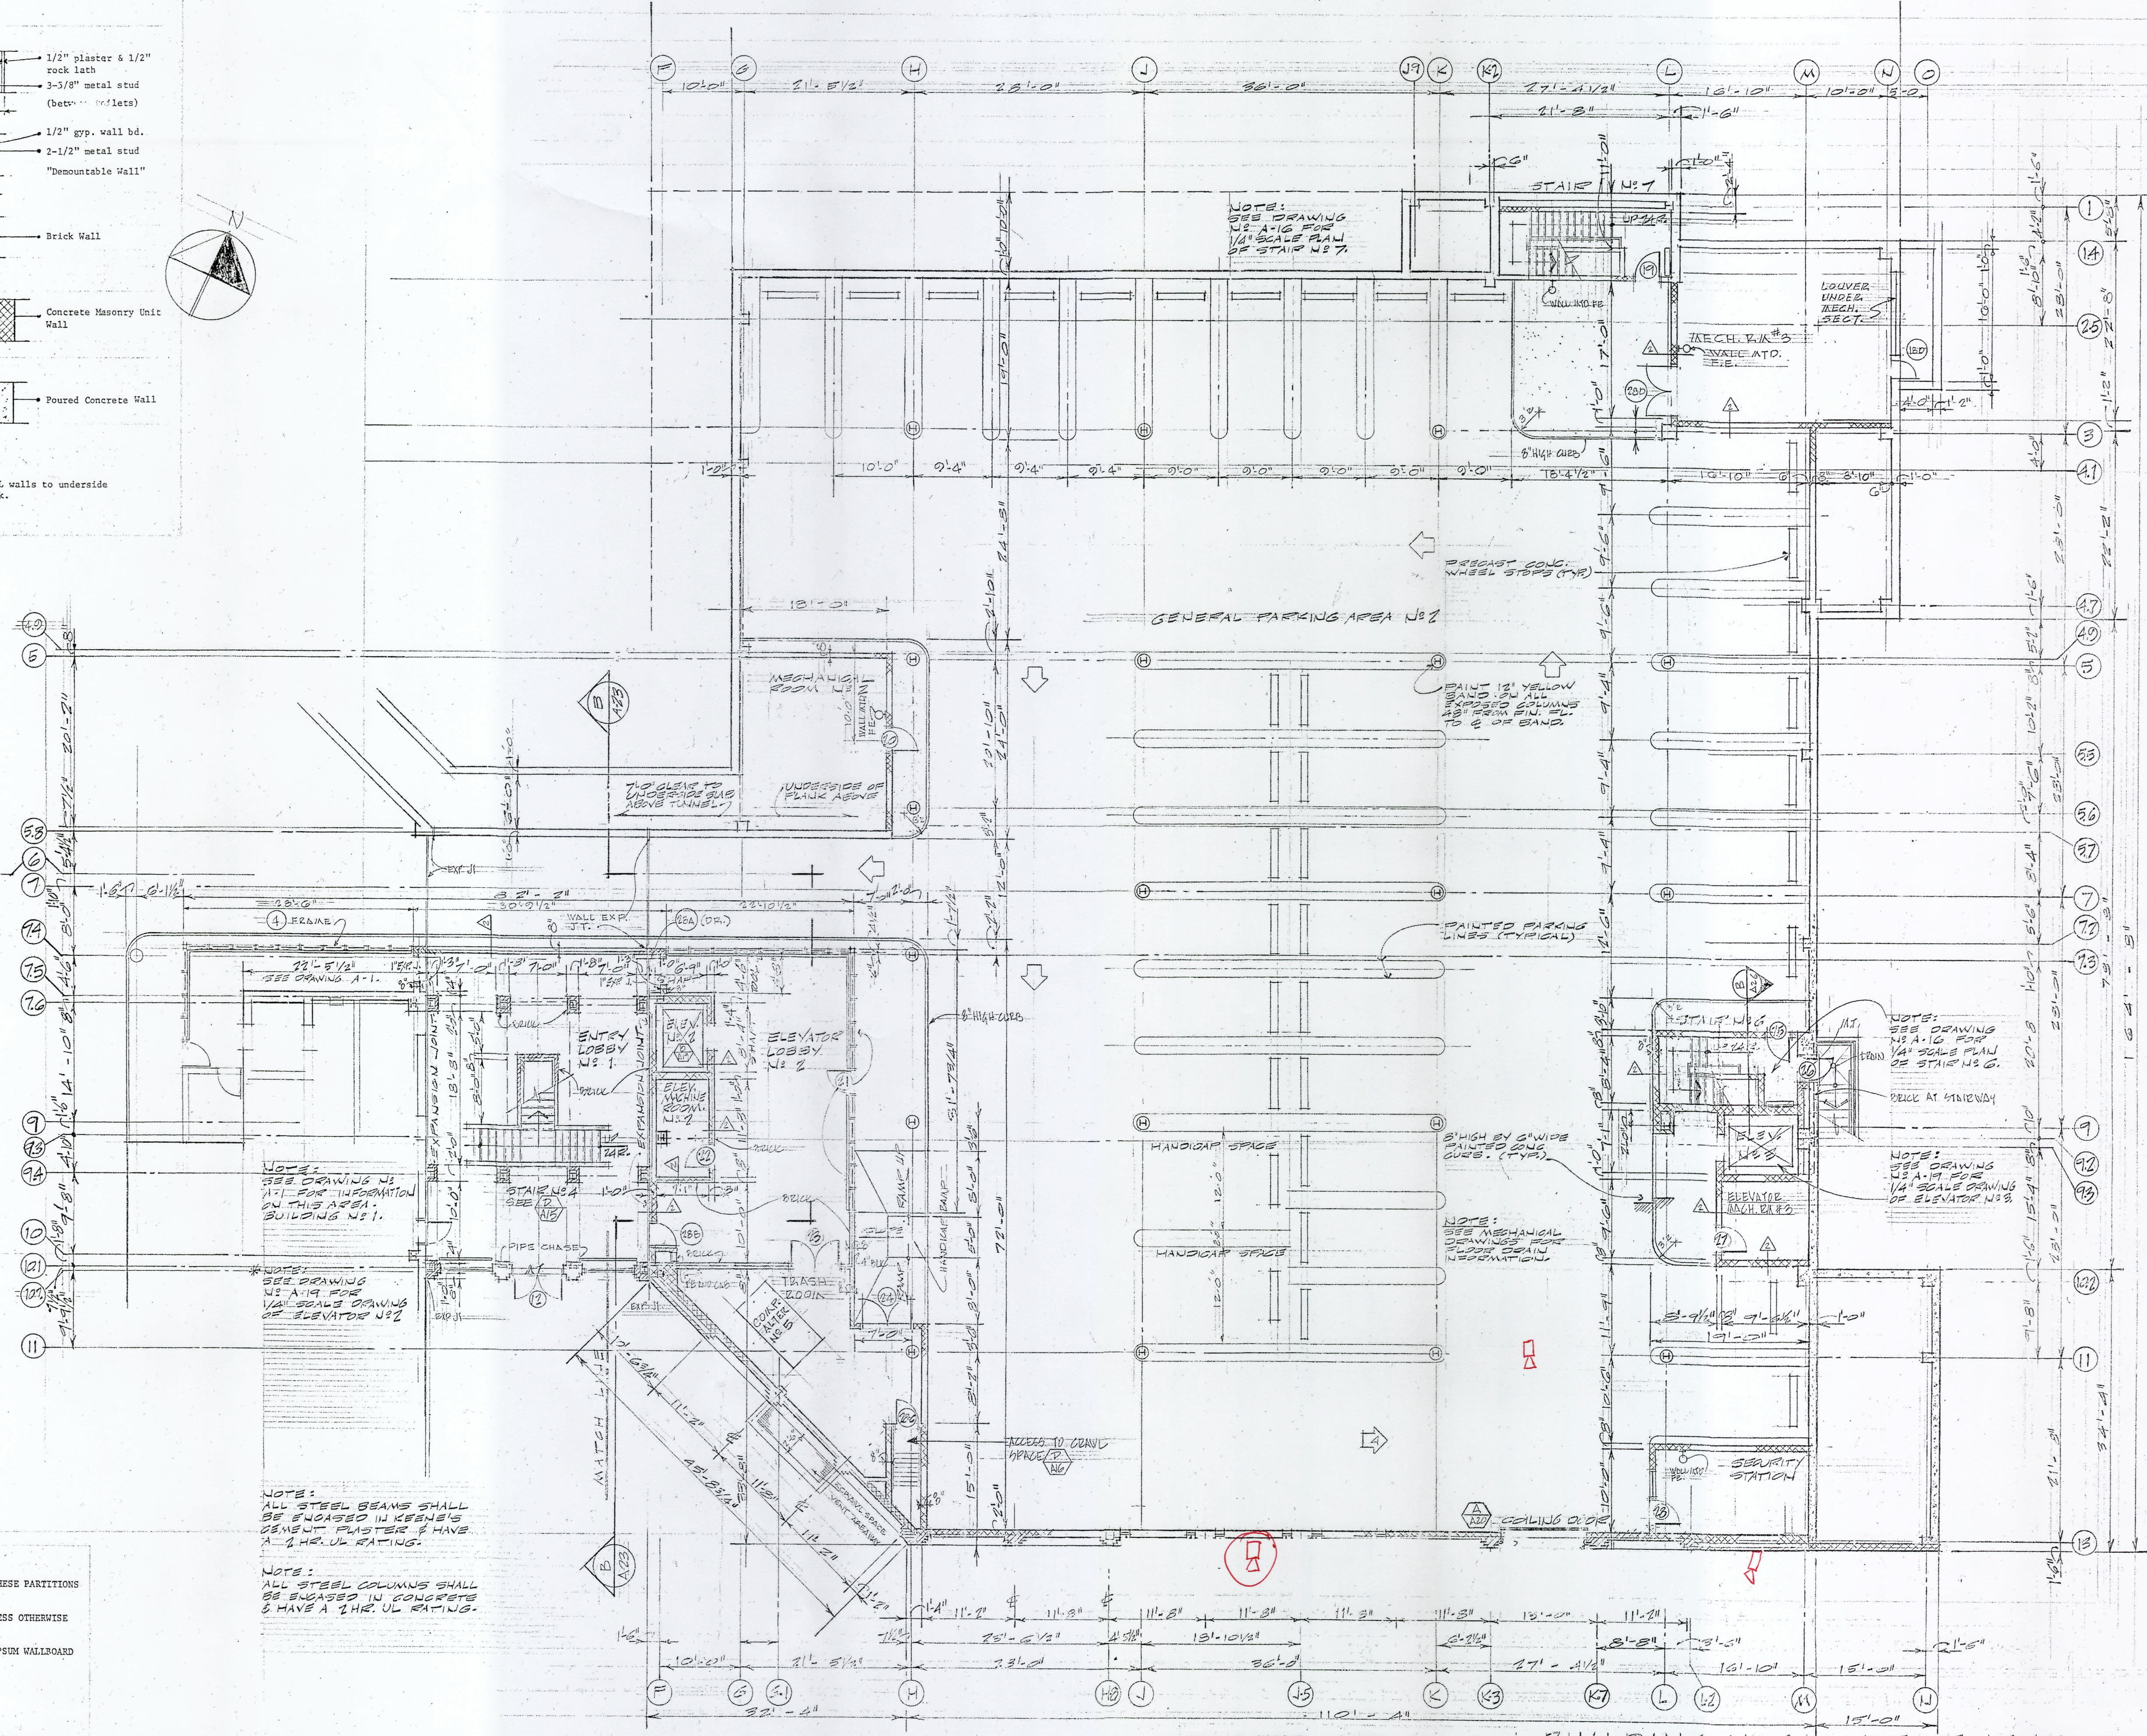

SMEALLIE, ORRICK & JANKA LTD.

ARCHITECTS · PLANNERS

5820 YORK ROAD
BALTIMORE, MARYLAND 21212

WHITNEY, BAILEY, COX & MAGNANI · CONSULTING ENGINEERS
GREEN SPRING STATION, SUITE 311 · 2380 WEST JOPPA ROAD · LUTHERVILLE, MD. 21093

GIFE ASSOCIATES · CONSULTANTS
201 PADONIA ROAD, WEST · TIMONIUM, MD. 21093

DAFT - McCUNE - WALKER, INC. · LANDSCAPE ARCHITECTS, PLANNERS
530 EAST JOPPA ROAD · TOWSON, MD. 21204

APPROVED

[Signature]

DATE: 11/26/80

APPROVED

[Signature]

DATE: 11-26-80

REVISION

DATE: 9/83

THE INFORMATION INDICATED BY THIS DRAWING HAS BEEN OBTAINED FROM THE ORIGINAL CONTRACT DOCUMENTS AND FROM RECORD DRAWINGS IN THE CONSTRUCTION AS PROVIDED BY THE CONTRACTOR.

DESIGNED, CHECKED AND DRAWN BY: S. JANKA, JR. AND J. ORRICK

DATE: 11-26-80

ELKTON DISTRICT COURT / MULTI SERVICE CENTER

MAIN STREET
ELKTON, MARYLAND

DATE: 11-26-80

JOB NO. BC-7330

DRAWING NO. OF A-2